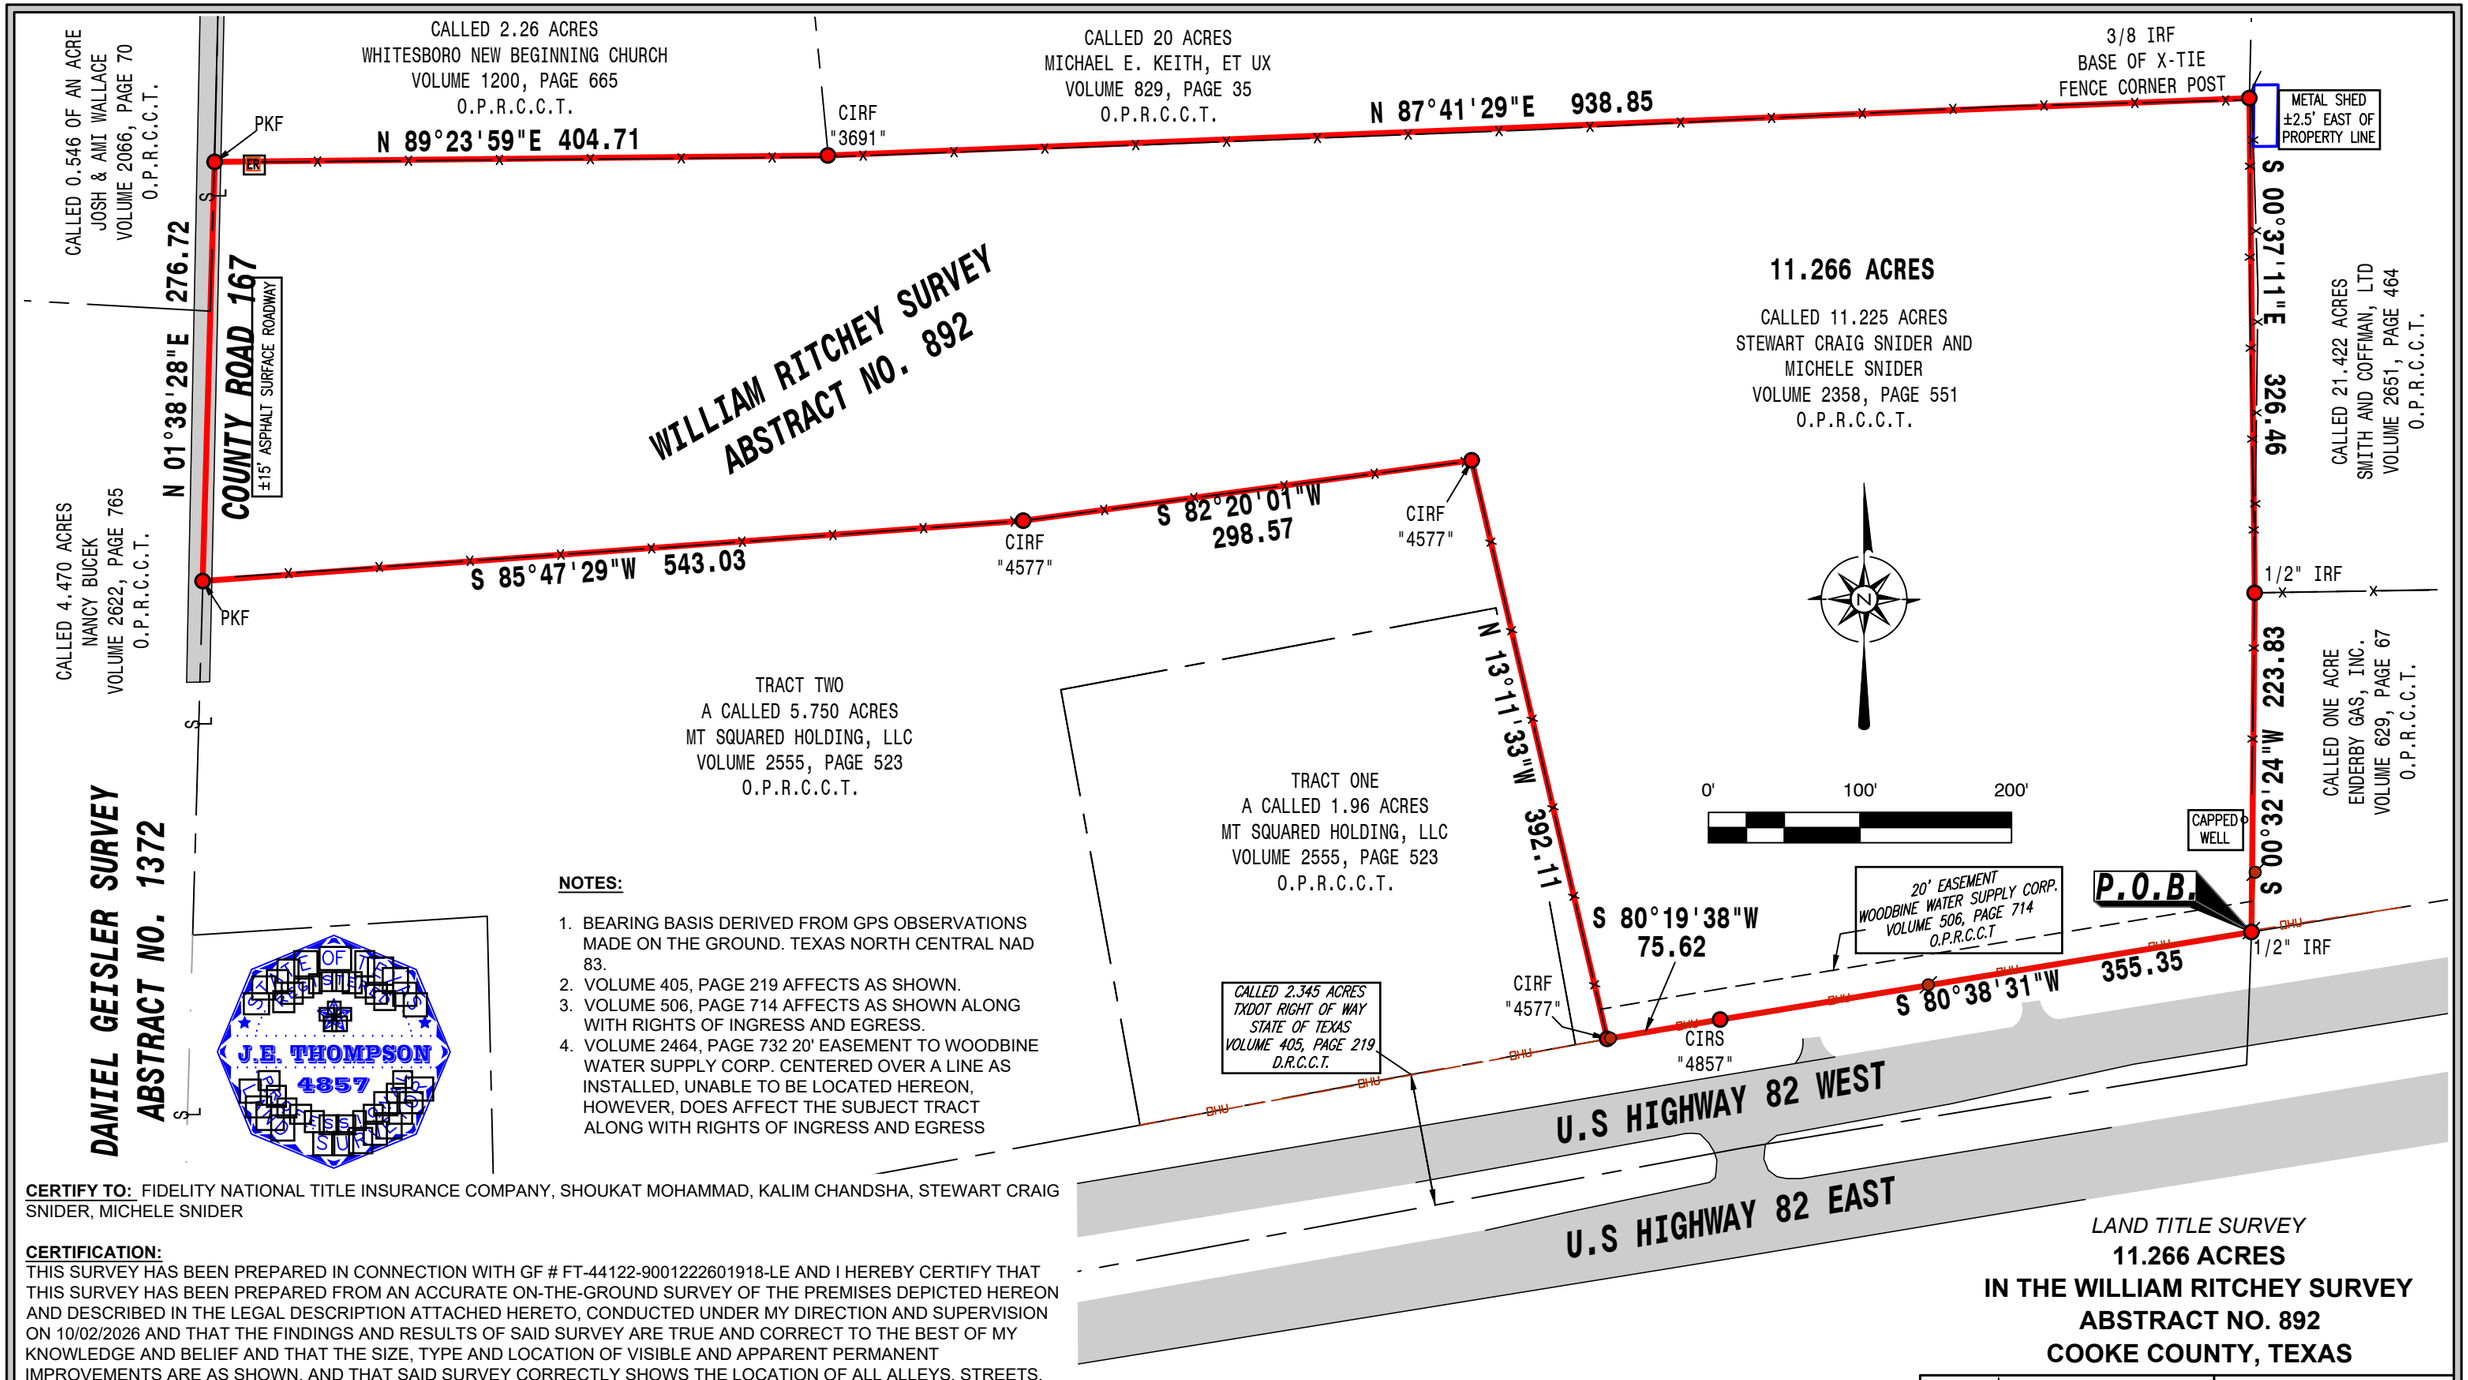


NOTES:

1. BEARING BASIS DERIVED FROM GPS OBSERVATIONS MADE ON THE GROUND. TEXAS NORTH CENTRAL NAD 83.
2. VOLUME 405, PAGE 219 AFFECTS AS SHOWN.
3. VOLUME 506, PAGE 714 AFFECTS AS SHOWN ALONG WITH RIGHTS OF INGRESS AND EGRESS.
4. VOLUME 2464, PAGE 732 20' EASEMENT TO WOODBINE WATER SUPPLY CORP. CENTERED OVER A LINE AS INSTALLED, UNABLE TO BE LOCATED HEREON, HOWEVER, DOES AFFECT THE SUBJECT TRACT ALONG WITH RIGHTS OF INGRESS AND EGRESS

CERTIFY TO: FIDELITY NATIONAL TITLE INSURANCE COMPANY, SHOUKAT MOHAMMAD, KALIM CHANDSHA, STEWART CRAIG SNIDER, MICHELE SNIDER

CERTIFICATION:

THIS SURVEY HAS BEEN PREPARED IN CONNECTION WITH GF # FT-44122-9001222601918-LE AND I HEREBY CERTIFY THAT THIS SURVEY HAS BEEN PREPARED FROM AN ACCURATE ON-THE-GROUND SURVEY OF THE PREMISES DEPICTED HEREON AND DESCRIBED IN THE LEGAL DESCRIPTION ATTACHED HERETO, CONDUCTED UNDER MY DIRECTION AND SUPERVISION ON 10/02/2026 AND THAT THE FINDINGS AND RESULTS OF SAID SURVEY ARE TRUE AND CORRECT TO THE BEST OF MY KNOWLEDGE AND BELIEF AND THAT THE SIZE, TYPE AND LOCATION OF VISIBLE AND APPARENT PERMANENT IMPROVEMENTS ARE AS SHOWN, AND THAT SAID SURVEY CORRECTLY SHOWS THE LOCATION OF ALL ALLEYS, STREETS, MAINTAINED RIGHTS-OF-WAY, AND EASEMENTS OF RECORD, AS SUPPLIED TO ME, OF WHICH THE UNDERSIGNED IS AWARE OR HAS BEEN ADVISED AFFECTING THE SUBJECT PREMISES ACCORDING TO THE DESCRIPTIONS OF RECORD, AND THAT EXCEPT AS SHOWN THERE ARE NO VISIBLE OR APPARENT INTRUSIONS, CONFLICTS OR PROTRUSIONS.

J.E. Thompson

J.E. THOMPSON II R.P.L.S. No 4857

ERRORS: THE CLIENT OR CLIENT'S REPRESENTATIVES WILL HAVE 45 DAYS FROM THE DATE THE SURVEY WAS ISSUED TO CHANGE ANY MISSPELLINGS OR ANY ERRORS ON THE SURVEY REPORT, AFTER THIS TIME HAS EXPIRED ALL PARTIES INVOLVED MUST ACCEPT THE SURVEY AS ISSUED.

LAND TITLE SURVEY

11.266 ACRES

IN THE WILLIAM RITCHEY SURVEY

ABSTRACT NO. 892

COOKE COUNTY, TEXAS

ALL AMERICAN SURVEYING
111 N. DIXON ST.
GAINESVILLE, TX 76240
PH. 940-665-9105
FAX. 940-665-9106
TBPLS FIRM NO. 10048000

DRAWN BY:	DATE:	JOB NO.	SCALE:	PAGE:
RJH	10/05/2026	26232	1" = 100'	1 OF 2

11.266 ACRES
WILLIAM RITCHEY SURVEY
ABSTRACT NO. 892
COOKE COUNTY, TEXAS

FIELD NOTES TO ALL THAT CERTAIN TRACT OR PARCEL OF LAND SITUATED IN THE WILLIAM RITCHEY SURVEY, ABSTRACT NO. 892 IN COOKE COUNTY, TEXAS, BEING A RE-SURVEY OF A CA
OF LAND DESCRIBED IN THE DEED TO STEWART CRAIG SNIDER AND MICHELE SNIDER AS RECORDED IN VOLUME 2358, PAGE 551 OF THE OFFICIAL PUBLIC RECORDS OF COOKE COUNTY, T
PARTICULARLY DESCRIBED AS FOLLOWS:

BEGINNING AT A 1/2 INCH IRON ROD FOUND AT THE SOUTHEAST CORNER OF SAID 11.225 ACRE TRACT, AT THE SOUTHWEST CORNER OF A CALLED ONE ACRE TRACT OF LAND DESCRIBED
GAS, INC. RECORDED IN VOLUME 629, PAGE 67 OF SAID PUBLIC RECORDS AND IN THE NORTH RIGHT OF WAY LINE OF U.S. HIGHWAY 82;

THENCE SOUTH 80 DEGREES 08 MINUTES 31 SECONDS WEST WITH THE NORTH RIGHT OF WAY LINE OF SAID U.S. HIGHWAY 82 AND A SOUTH LINE OF SAID 11.225 ACRE TRACT FOR A DISTA
CAPPED IRON ROD STAMPED "4857" SET FOR CORNER;

THENCE SOUTH 80 DEGREES 08 MINUTES 38 SECONDS WEST WITH THE NORTH RIGHT OF WAY LINE OF SAID U.S. HIGHWAY 82 AND A SOUTH LINE OF SAID 11.225 ACRE TRACT FOR A DISTA
CAPPED IRON ROD STAMPED "4577" FOUND AT THE EASTERN MOST SOUTHEAST CORNER OF A CALLED 5.750 ACRE TRACT OF LAND DESCRIBED AS TRACT TWO IN THE DEED TO MT SQUAR
RECORDED IN VOLUME 2555, PAGE 523 OF SAID OFFICIAL PUBLIC RECORDS;

THENCE NORTH 13 DEGREES 11 MINUTES 33 SECONDS WEST WITH A WEST LINE OF SAID 11.225 ACRE TRACT AND AN EAST LINE OF SAID TRACT TWO, ALONG OR NEAR A FENCE FOR A DIS
A CAPPED IRON ROD FOUND FOR CORNER AT THE NORTHERN MOST NORTHEAST CORNER OF SAID TRACT TWO;

THENCE SOUTH 82 DEGREES 20 MINUTES 01 SECONDS WEST WITH A NORTH LINE OF SAID TRACT TWO AND A SOUTH LINE OF SAID 11.225 ACRE TRACT, ALONG OR NEAR A FENCE FOR A D
TO A CAPPED IRON ROD STAMPED "4577" FOUND FOR CORNER AT AN ANGLE POINT IN SAID LINE;

THENCE SOUTH 85 DEGREES 47 MINUTES 29 SECONDS WEST WITH SAID NORTH LINE OF TRACT TWO AND A SOUTH LINE OF SAID 11.225 ACRE TRACT, ALONG OR NEAR SAID FENCE FOR A
TO A PK NAIL FOUND FOR CORNER NEAR THE CENTER OF AN ASPHALT SURFACE ROADWAY UNDER APPARENT PUBLIC USE POSTED AS COUNTY ROAD 167, AT THE WESTERN MOST SOUTH
11.225 ACRE TRACT;

THENCE NORTH 01 DEGREE 38 MINUTES 28 SECONDS EAST WITH A WEST LINE OF SAID 11.225 ACRE TRACT, ALONG SAID COUNTY ROAD 167, FOR A DISTANCE OF 276.72 FEET TO A PK NAIL
THE NORTHWEST CORNER THEREOF AND AT THE SOUTHWEST CORNER OF A CALLED 2.26 ACRE TRACT OF LAND DESCRIBED IN THE DEED TO WHITESBORO NEW BEGINNING CHURCH AS
1200, PAGE 665 OF SAID OFFICIAL PUBLIC RECORDS;

THENCE NORTH 89 DEGREES 23 MINUTES 59 SECONDS EAST WITH THE NORTH LINE OF SAID 11.225 ACRE TRACT AND THE SOUTH LINE OF SAID 2.26 ACRE TRACT, ALONG OR NEAR A FENC
404.71 FEET TO A CAPPED IRON ROD STAMPED "3691" FOUND AT THE BASE OF A FENCE POST FOR CORNER AT THE SOUTHEAST CORNER THEREOF AND THE SOUTHERN MOST SOUTHWES
ACRE TRACT OF LAND DESCRIBED IN THE DEED TO MICHAEL E. KEITH, ET UX, AS RECORDED IN VOLUME 829, PAGE 35 OF SAID PUBLIC RECORDS;

THENCE NORTH 87 DEGREES 41 MINUTES 29 SECONDS EAST WITH A SOUTH LINE OF SAID 20 ACRE TRACT AND THE NORTH LINE OF SAID 11.225 ACRE TRACT, ALONG OR NEAR FENCE, FOR
FEET TO A 3/8 INCH IRON ROD FOUND FOR CORNER AT THE SOUTHEAST CORNER OF SAID 20 ACRE TRACT, THE NORTHEAST CORNER OF SAID 11.225 ACRE TRACT, AND IN A WEST LINE OF
TRACT OF LAND DESCRIBED IN THE DEED TO SMITH AND COFFMAN, LTD, AS RECORDED IN VOLUME 2651, PAGE 464 OF SAID PUBLIC RECORDS;

THENCE SOUTH 00 DEGREES 37 MINUTES 11 SECONDS EAST WITH A WEST LINE OF SAID 21.422 ACRE TRACT AND THE EAST LINE OF SAID 11.225 ACRE TRACT, ALONG OR NEAR A FENCE, F
FEET TO A 1/2 INCH IRON ROD FOUND FOR CORNER AT THE WESTERN MOST SOUTHWEST CORNER OF SAID 21.422 ACRE TRACT AND THE NORTHWEST CORNER OF SAID ONE ACRE TRACT

THENCE SOUTH 00 DEGREES 32 MINUTES 24 SECONDS WEST WITH THE WEST LINE OF SAID ONE ACRE TRACT AND THE EAST LINE OF SAID 11.225 ACRE TRACT, ALONG OR NEAR A FENCE,
FEET TO THE PLACE OF BEGINNING AND CONTAINING 11.266 ACRES OF LAND, MORE OR LESS.

CERTIFY TO: FIDELITY NATIONAL TITLE INSURANCE COMPANY, SHOUKAT MOHAMMAD, KALIM CHANDSHA, STEWART CRAIG SNIDER, MICHELE SNIDER

CERTIFICATION:
THIS SURVEY HAS BEEN PREPARED IN CONNECTION WITH GF # FT-44122-9001222601918-LE AND I HEREBY CERTIFY THAT THIS SURVEY HAS BEEN PREPARED FROM AN ACCURATE ON THE GROUND SURVEY OF THE PREMISES DEPICTED HEREON AND DESCRIBED IN THE LEGAL DESCRIPTION ATTACHED HERETO, CONDUCTED UNDER MY DIRECTION AND SUPERVISION ON 10/02/2026 AND THAT THE FINDINGS AND RESULTS OF SAID SURVEY ARE TRUE AND CORRECT TO THE BEST OF MY KNOWLEDGE AND BELIEF AND THAT THE SIZE, TYPE AND LOCATION OF VISIBLE AND APPARENT PERMANENT IMPROVEMENTS ARE AS SHOWN, AND THAT SAID SURVEY CORRECTLY SHOWS THE LOCATION OF ALL ALLEYS, STREETS, MAINTAINED RIGHTS-OF-WAY, AND EASEMENTS OF RECORD, AS SUPPLIED TO ME, OF WHICH THE UNDERSIGNED IS AWARE OR HAS BEEN ADVISED AFFECTING THE SUBJECT PREMISES ACCORDING TO THE DESCRIPTIONS OF RECORD, AND THAT EXCEPT AS SHOWN THERE ARE NO VISIBLE OR APPARENT INTRUSIONS, CONFLICTS OR PROTRUSIONS.

J.E. THOMPSON II R.P.L.S. No 4857

J.E. THOMPSON
4857

ERRORS: THE CLIENT OR CLIENT'S REPRESENTATIVES WILL HA
SURVEY WAS ISSUED TO CHANGE ANY MISSPELLINGS OR ANY
AFTER THIS TIME HAS EXPIRED ALL PARTIES INVOLVED MUST